PETITION FOR SPECIAL EXCEPTION 15-56-4 TO THE ZONING COMMISSIONER OF BALTIMORE COUNTY: The undersigned, legal owner(s) of the property situate in Saltimore County and which is described in the description and plat attached hereto and made a part hereof, hereby petition for a Special Exception under the Zoning Law and Zoning Regulations of Baltimore County, to use the herein described property for the use of a food store with less than 5,000 square feet in combination with an existing service station under Section 405.4 (D.8) Property is to be posted and advertised as prescribed by Zoning Regulations. I, or we, agree to pay expenses of above Special Exception advertising, posting, etc., upon filing of this petition, and further agree to and are to be bound by the zoning regulations and restrictions of Baltimore County adopted pursuant to the Zoning Law for Baltimore County. I/We do solemnly declare and affirm, under the penalties of perjury, that I/we are the legal owner(s) of the property which is the subject of this Pe_tion. (Lessee) Legal Owner(s): Shell 011 Company Equitable Life Assurance Soc. of the U.S. (Type of Pript Name) 4 155'T, RICIONA PROPERTY Signature H.L. Johnston 5565 Sterrett Place Columbia, Maryland 21044 City and State Attorney for Petitioner: 1875 EYE ST. N.W. 202-715-83Ke WASHER D. C. 2000 e, address and phone number of legal owner, conscious Steve McCalmont, c/o Lyon Associates City and State 7131 Rutherford Road Baltimore, MD 21207 required by the Zoning Law of Baltimore County, in two newspapers of general circulation throughout Baltimore County, that property be posted, and that the public hearing be had before the Zoning Commissioner of Baltimore County in Room 106, County Office Building in Towson, Baltimore County, on the 27th day of August, 1984, at 10:30 o'clock --A---M. 2.C.O.—No. 1 HARRY J. PISTEL, P. E. DIRECTOR County Office Building
111 W. Chesapeake Avenue
Towson, Maryland 21204 Your petition has been received and accepted for filing this day of July 19 84 Zoning Commissioner Equitable Life Assurance Petitioner Society of U. S. Chairman, Zoning Plans Advisory Committee

BALTIMORE COUNTY ZCING PLANS ADVISORY COMMITTEE

PETITION AND SITE PLAN

EVALUATION COMMENTS

BALTIMORE COUNTY, MARYLAND

INTER-OFFICE CORRESPONDENCE

Arnold Jablon TO Zoning Commissioner Date___August 10, 1984 Norman E. Gerber, Director

FROM Office of Planning and Zoning

SUBJECT Zoning Petition No. 85-56-X

This office is not opposed to the granting of the subject request; however, particular attention should be given to the requirements set forth in the Division of Current Planning and Development's comment to the Zoning Plans Advisory Committee.

Office of Planning and Zoning

NEG/JGH/sf

BALTIMORE COUNTY ZONING PLANS ADVISORY COMMITTEE

August 16, 1984 Mr. R. M. Tambascio COUNTY OFFICE BLDG. 111 W. Chesapeake Ave. Towson, Maryland 21204 Shell Oil Company

5565 Sterrett Place Columbia, Maryland 21044 Nicholas B. Commodar

Chairman

Zoning Administration

Burcau of

RE: Item No. 356 - Case No. 85-56-X Equitable Life Assurance Soc. U. S. Special Exception Petition

Dear Mr. Tambascio:

The Zoning Plans Advisory Committee has reviewed the plans submitted with the above referenced metition. The following comments are not intended to indicate the approtateness of the zoning action requested, but to assure regard to the development plans or problems with this case. The Director of Planning may file a written as to the suitability of the requested zoning. Department of Traffic Engineering gareau of Mealth Department Project Planning Building Department Board of Education

Enclosed are all comments submitted from the members of the Committee at this time that offer or request information on your petition. If similar comments from the otherwise, any comment that is not informative will be filing on the date of the enclosed filing certificate and a scheduled accordingly.

Very truly yours,

Techsler B. Commadaic . Loc NICHOLAS B. COMMODARI Chairman

Zoning Plans Advisory Committee

Enclosures

NBC:bsc

cc: Lyon Associates
7131 Rutherford Road Baltimore, Md. 21207 Steve McCalmont

BALTIMORE COUNTY
DEPARTMENT OF PUBLIC WORKS
TOWSON, MARYLAND 21204

L-SE Key Sheet 6 NW 23 Pos. Sheet NW 2 F Topo 95 Tax Map

July 13, 1984

Mr. Arnold Jablon Zoning Commissioner County Office Building Towson, Maryland 21204

> Re: Item #356 (1983-1984) Property Owner: Equitable Life Assurance Soc. of the U.S. N/W cor. Security Blvd. and Woodlawn Dr. Acres: 0.709 District: 1st

Dear Mr. Jablon:

The following comments are furnished in regard to the plat submitted to this office for review by the Zoning Advisory Committee in connection with the subject

The comments, which were supplied for this property in conjunction with the Zoning Advisory Committee review for Item 259 (1975-1976) are referred to for your

Baltimore County highway and utility improvements exist and are not directly

Development of this property through stripping, grading and stabilization could result in a sediment pollution problem, damaging private and public holdings downstream of the property. A grading permit is, therefore, necessary for all grading, including the stripping of top soil.

The Petitioner must provide necessary drainage facilities (temporary or permanent) to prevent creating any nuisances or damages to adjacent properties, especially by the concentration of surface waters. Correction of any problem which may result, due to improper grading or improper installation of drainage facilities, would be the full responsibility of the Patitioner.

This office has no further comment in regard to the plan submitted for Zoning Advisory Committee review in connection with this Item 356 (1983-1984).

> Very truly yours, GILBERT S. BENSON, P.E., Asst. Chief Bureau of Public Services

GSB:EAM:FWR:ss

Encls.

August 3, 1976

Mr. S. Eric DiNenna Zoning Commissioner County Office Building Towson, Maryland 21204

> Re: Item #259 (1975-1976) Property Owner: Shell Oil Company N/W cor. Sacurity Blvd. & Woodlawn Dr. Existing Zoning: BM - CCC Proposed Zoning: Variance for area of free-standing to be 112 sq. ft. in lieu of the required 100 sq. ft. District: 1st

Dear Mr. DiNenna:

The following comments are furnished in regard to the plat submitted to this office for review by the Zoning Advisory Committee in connection with the subject Item. General:

Baltimore County highway and utility improvements are not directly involved. The construction or reconstruction of sidewalk, curb and gutter, entrances, aprons, etc. as may be required, will be the full responsibility of the Petitioner. This office has no further comment in regard to the plan submitted for Zoning Advisory Committee review in connection with this Item #259 (1975-1976).

ELISWORTH N. DIVER, P.E. Chief, Bureau of Engineering

END: EAM: FWR: SS

L-SE Key Sheet 6 NW 23 Pos. Sheet NW 2 F Topo 95 Tax Map

Mr. Arnold Jablon Zoning Commissioner County Office Building Towson, Maryland 21204

Re: Zoning Advisory Meeting of 7/3/84

Item # 3-56

Property Owner: Equitable Life Assurance Society
Location: While Security BLVD, THE U.S.A,

WOODLAWN DR,

The Division of Current Planning and Development has reviewed the subject petition and offers the following comments. The Items checked below are

)A record plat will be required and must be recorded prior)A record plat will be required and must be recorder to issuance of a building permit.
)The access is not satisfactory.
)The circulation on this site is not satisfactory.
)The parking arrangement is not satisfactory.
)Parking calculations must be shown on the plan.)This property contains soils which are defined as wetlands, and development on these soils is prohibited.

)Construction in or alteration of the floodplain is prohibited under the provisions of Section 22-98 of the Development Regulations.

Development of this site may constitute a potential conflict with the Baltimore County Master Plan.

The amended Development Plan was approved by the Planning Board

LAUSS Landscaping enters be provided on this site and shown on the plan. The property is located in a deficient service area as defined by Bill 178-79. No building perait may be issued until a Reserve Capacity Use Certificate has been issued. The deficient service

1s flot

() The property is located in a traffic area controlled by a "D" level intersection as defined by Bill 178-79, and as conditions change traffic capacity may become more limited. The Basic Services Areas are re-evaluated annually by the County Council. T - 285

() Additional comments:

THIS IS PART OF A SHOPPING CENTER AND A COPY OF THE OVERALL PLAN MUST BE SUBMITTED.

BALTIMORE COUNTY
DEPARTMENT OF PERMITS & LICENSES
TOWSON MARYLAND 21204
494-3610

Equitable Life Assurance Soc. of the U.S.

5,000 sq. ft. with an existing service station

Special Exception for the use of food store with less than

Security Blvd & Woodlawn Drive

A. All structure shall conform to the Baltimore County Building Code 1981/ Council Bill 1-82 State of Haryland Code for the Handicapped and Aged; and other applicable Codes.

(B.) a building/and other miscellaneous permits shall be required before beginning

D. Commercial: Three sets of construction drawings with a Maryland Registered Architect or Engineer shall be required to file a permit application.

F. Requested variance conflicts with the Baltimore County Building Code, Section/s

G. Residentials Three sets of construction drawings are required to file a permit application. Architect/Engineer seal is/is not required.

3. An exterior wall erected within 6'0 of an adjacent lot line shall be of one hour fire resistive construction, no openings permitted within 3'-0 of lot lines. A firewall is required if construction is on the lot line, See Table 401, line 2, Section 1407 and Table 1402.

G. A change of occupancy shall be applied for, along with an alteration permit application, and three required sets of drawings indicating how the structure will meet the Code requirements for the proposed change. Drawings may require

H. Before this office can comment on the above structure, please have the owner, thru the services of a Ragistered in Maryland Architect or Engineer certify to this office, that, the structure for which a proposed change in use is proposed can comply with the height/area requirements of Table 505 and the required construction classification of Table 101.

EOTE: These comments reflect only on the information provided by the drawings submitted to the office of Planning and Zoning and are not intended to be construed as the full extent of any permit.

(1) comments: Should the Buildings Be prefabricated they shall bear a state deal for Industrializes Blde's

Yery truly yours,

Charles E. Burnhes, Chief

Office of Planning and Zoning

TED ZALESKI, JR. DIRECTOR

FOLM 01-82

kn#

lowson, Maryland

Pursuant to the advertisement, posting of property, and public hearing on the Petition and if appearing that by reason of the requirements of Section 502.1 of the Baltimore County Zoning

IT IS ORDERED by the Zoning Commissioner of Baltimore County, this

BALTIMORE COUNTY
DEPARTMENT OF TRAFFIC ENGINEERING
TOWSON, MARYLAND 21204

Mr. Arnold Jablon Zoning Commissioner County Office Building Towson, Maryland 21204

> Item No. 345, 356, 357, 358, 359, 360, 361 ZAC-Meeting of July 3, 1984 Location: Existing Zoning: Proposed Zoning:

Acres: District:

Dear Mr. Jablon:

numbers 315, 356 The Department of Traffic Engineering has no comments for iter

Traffic Engineering Assoc. II

RE: PETITION FOR SPECIAL EXCEPTION: BEFORE THE ZONING COMMISSIONER NW/Corner Security Blvd. and Woodlawn Dr., 2nd District OF BALTIMORE COUNTY EQUITABLE LIFE ASSURANCE SOC. : Case No. 85-56-X OF THE U. S., Petitioner

ENTRY OF APPEARANCE

:::::::

Please enter the appearance of the People's Counsel in the above-captioned matter. Notices should be sent of any hearing dates or other proceedings in this matter and of the passage of any preliminary or final Order.

> Phyllis Cole Friedman
>
> Phyllis Cole Friedman People's Counsel for Baltimore County

Peter Max Zimmerman Deputy People's Counsel Rm. 223, Court House Towson, MD 21204 494-2188

I HEREBY CERTIFY that on this 8th day of August, 1984, a copy of the foregoing Entry of Appearance was mailed to H. L. Johnston, Asst. Regional Property Manager, Equitable Life Assurance Society of the U.S., 1375 Eye Street, N. W., Washington, D. C. 20006, Petitioner; Shell Oil Company, 5565 Sterrett Place, Columbia, MD 21044, Lessee; and Mr. Steve McCalmont, c/o Lyon Associates, 7131 Rutherford Rd., Baltimore, MD 21207, who requested notification.

Peter Max Zimmerman

County Board of Appeals of Baltimore County Room 200 Court House (Hearing Room #218) Towson, Maryland 21204 (301) 494-3180

July 18, 1984

Zoning Agenda: Meeting of July 3, 1984

NOTICE OF ASSIGNMENT

November 16, 1984

NO POSTPONEMENTS WILL BE GRANTED WITHOUT GOOD AND SUFFICIENT REASONS. REQUESTS FOR POSTPONEMENTS MUST BE IN WRITING AND IN STRICT COMPLIANCE WITH BOARD RULE 2(b). ABSOLUTELY NO POSTPONE-MENTS WILL BE GRANTED WITHIN FIFTEEN (15) DAYS OF SCHEDULED HEAR-ING JATE IN ACCORDANCE WITH RULE 2(c), COUNTY COUNCIL BILL \$59-79

CASE NO. 85-56-X

BALTIMORE COUNTY FIRE DEPARTMENT TOWSON, MARYLAND 21204-2586 494-4500

Office of Planning and Zoning

Attention: Nick Commodari, Chairman

Department of Public Works.

() 3. The vehicle dead end condition shown at

() 6. Site plans are approved, as drawn.

Special Inspection Division

/mb * See attached sheet.

Zoning Plans Advisory Committee

RE: Property Owner: Equitable Life Assurance Soc. of the U.S.

Pursuant to your request, the referenced property has been surveyed by this

Bureau and the comments below marked with an "X" are applicable and required

() 1. Fire hydrants for the referenced property are required and shall be

located at intervals or _____ feet along an approved road in accordance with Baltimore County Standards as published by the

Fire Prevention Code prior to occupancy or beginning of operation.

REVIEWER: Cuft. Joseph J. 1-18-14 Approved: Long Milliam Fire Prevention Bureau

comply with all applicable requirements of the National Fire Protecti Association Standard No. 101 "Life Safety Code", 1976 Edition prior

Location: NW/Cor. Security Blvd. and Woodlawn Drive

to be corrected or incorporated into the final plans for the property.

() 2. A second means of vehicle access is required for the site.

EXCEEDS the maximum allowed by the Fire Department.

() 7. The Fire Prevention Bureau has no comments, at this time.

• (x) 4. The site shall be made to comply with all applicable parts of the

 (χ) 5. The buildings and structures existing or proposed on the site shall

Baltimore County Office Building

PAUL H. REINCKE Chief

Mr. Arnold Jablon Zoning Commissioner

Towson, MD 21204

EQUITABLE LIFE ASSURANCE SOC. OF THE U. S.

NW/corner Security Blvd. and Woodlawn Drive

1st District

SE-The use of a food store with less than 5,000 sq. ft. in combo. w/existing service station

ASSIGNED FOR:

THURSDAY, JANUARY 31, 1985, at 10 a.m.

cc: H. L. Johnston R. M. Tambascio

Petitioner Lessee (Shell Oil Co.)

People's Counsel

Steve McCalmont Lessee's Engineer

Walter J. Caton, Sr. **Protestants** W. Bell Merchants Association

Phyllis C. Friedman

N. E. Gerber J. Hoswell

A. Jablon

J. Jung

Entered 1/28/85 - John O. Seiland, Esquire Counsel for Lessee (Shell Oil Co.) . Page -2-

Zoning item #356

Zoning Agenda 7/3/84

All self-service stations shall have at least one attendant on duty while station is open to the public. The attendant's primary function shall be to supervise, observe and control the dispensing of Class I liquors while said liquids are actually being dispensed according to NFPA 30, section 7-7.4.3.

W. BELL SHOPPING PLAZA

Phone: 944-1221


MERCHANTS ASSOCIATION, INC. 6642 SECURITY BLVD. BALTIMORE, MD. 21207

September 20, 1984

Baltimore County Maryland Zoning Department Room # 109

On behalf of the W. Bell Merchants Association, we wish to appeal the decision on case # 85-56x, as there was no notice posted until sometime in September 1984.

If in fact there was a sign posted, it was not posted where it is now posted, where it could be seen easily; Not until September.

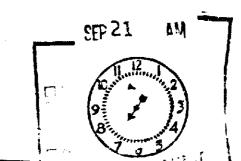

vice-president W. Bell Merchants Association

BALTIMORE COUNTY, MARYLAND OFFICE OF FINANCE - REVENUE DIVISION MISCELLANEOUS CASH RECEIPT

No. 134358

DATE 9/26/84 ACCOUNT R-01-515-000 RECEIVED W. Bell Shopping Flara Appeal of Case No. 85-56-X

(Equitable Life Assurance Soc. of the U.S.)

G 847****105D014 8274F

June Holmen, Secv.

BALTIMORE COUNTY OFFICE OF PLANNING & ZONING TOWSON, MARYLAND 21204 494-3353	IN RE: PETITION FOR * BEFORE THE SPECIAL EXCEPTION NW/corner Security Boulevard and Woodlawn Drive lst Election District * BOARD OF APPEALS	July 30, 1.04 Shell Oil Company c/o R. W. Tambascio	
ARNOLD JABLON ZONING COMMISSIONER	* OF EALTIMORE COUNTY Equitable Life Assurance Soc. of the U.S., * Case No. 85-56-X	5565 Sterrett Place Jelumbia, Marylard 21044	
September 27, 1984	Petitioner	NOTICE OF HEARING Re: Petition for Special Exception WW/cor. Security Blvd. 4 Woodlavn Dr. Iquitable Life Assurance Soc. of the U.S Petitioner	
Mr. H.L. Johnston Assistant Regional Property Manager Equitable Life Assurance Soc. of the U.S.	Entry of Appearance	Case No. 85-56-X	CERTIFICATE OF POSTING ZONING DEPARTMENT OF BALTIMORE COUNTY
1875 Eye Street, N.W. Washington, D.C. 20006	Please enter my appearance as a party in the above captioned matter,	TIME: 10:30 A.H.	Townen, Maryland 85-56-X
RE: Petition for Special Exception NW/corner Security Boulevard and Woodlawn Drive	pursuant to Section 501.6, B.C.Z.R., and I hereby request that any and all notices be forwarded to my office, including but not limited to hearing dates	DATE: Konday, August 27, 1984	District 2nd Date of Posting 8-18-84
Equitable Life Assurance Soc. of the U.S Petitioner Case No. 85-56-X	and/or preliminary or final Orders.	PLACE: Room 106, County Office Building, 111 West Chesapeake Avenue, Towson, Maryland	Posted for: Special Exception. Petitioner: Equation tipe assurance Sociof the U.S.
Dear Mr. Johnston:		ce: Stave McCalmont	Location of property: NW/ Corner, Security Block and Wird Lawn Dr.
Please be advised that an appeal has been filed by the Protestants, W. Bell Merchants Association, from the decision rendered by the Zoning Commissioner of Baltimore County in the above referenced matter.	Arnold Jahlon Zoning Commissioner of Baltimore County	c/o Lyon Associates 7131 Rutherford Road Baltimore, Haryland 21207	Location of Signs: NWf Corner of Santy Block Buch Wordleson Shin
You will be notified of the date and time of the appeal hearing when it is scheduled by the County Board of Appeals.	Room 109 - 111 West Chesapeake Avenue Towson, Maryland 21204 494-3353		Posted by S. Quala Date of return: 8-17-54
Sincerely, ARNOLD JABLON	Certificate of Mailing	Zoning Commissioner of Baltimore County	Signature Number of Signs:
Zoning Commissioner AJ:eoh	IT IS HEREBY CERTIFIED that on this27th day of September 1984, copies of the foregoing Entry of Appearance were mailed, postage prepaid,		
cc: Mr. R. M. Tambascio Shell Oil Company	by first class delivery to the County Attorney of Baltimore County, People's	BALTIMORE COUNTY, MARYLAND OFFICE OF FINANCE - REVENUE DIVISION MISCELLANEOUS CASH RECEIPT	
5565 Sterrett Place Columbia, Maryland 21044	Counsel for Baltimore County, Petitioner(s) and/or Protestant(s) in the above	DATE 6/14/81/ ACCOUNT K-01-615:000	
Mr. Steve McCalment Lyon Associates 7131 Rutherford Roau	captioned matter.	AMOUNT /OJ: DD	
Baltimore, Maryland 21207 People's Counsel	Arnold Jabion	FOR fling fel pa don H 356	
		C U75************	
		VALIDATION OR SIGNATURE OF CASHIER	
Petition for Special Exception 2nd Election District Coning: Petition for Special Exception Location: Northwest corner Security			
Boulevard and Woodlawn During 27, 1984 at Date & Time: Monday, August 27, 1984 at 10:30 a.m. 108, County Office Put to Hearing: County Office		BALTIMORE COUNTY OFFICE OF PLANNING & ZONING TOWSON, MARYLAND 21204 494-3353	STY/LYON ASSOCIATES. ENGINEERS, ARCHITECTS & PLANNERS. 21 GOVERNOR'S COURT
The Zoning Commissioner of Baitimore County, by authority of the Zoning Act and Recounty of Baitimore County, will hold a			21 GOVERNORS COURT BALTIMORE MD 21207-2722 301/944-9112
public hearing: Petition for Special Exception for the use of a Petition Fixe Special Exception for the use of a Petition Fixe Special Exception for the use of a Petition for the use of		ARNOLD JABLON ZONING COMMISSIONER	ZONING DESCRIPTION
under Section 405.4 (D.8) Being the property of Equitable Life Being the property of Equitable Life Assurance Soc. of the U.S., as shown on plat Assurance Soc. of the U.S., as shown on plat plan filed with the Zoning Copartment. In the event that this Pointion is granted, a builting permit may be Issued within the thirty (30) day appeal period. The Zoning Com- thirty (30) day appeal period. The Zoning Com- missioner with, however, entertain any request	PETITION FOR SPECIAL O	August 23, 1984	EXISTING SHELL SERVICE STATION NW/corner of SECURITY BOULEVARD AND WOODLAWN DRIVE
for a stay of the issuance of some shown. Such ing this period for good cause shown.	EXCEPTION 2nd Election District CERTIFICATE OF PUBLICATION ZONING: Petition for Special Exception	Lyon Associates	BEGINNING FOR THE SAME at a point located along the Northern right- of-way line of Security Boulevard at the intersection of Security
request must be received at the date of the hearing set above or made at the date of the hearing set above or made at the day of hearing. By Order of Arnold Jablon Zoning Commissioner of Baltimore County	LOCATION: Northwest corner Security Boulevard and Woodlawn Drive TOWSON, MD.,August 9,, 19.84_	c/o Steve McCalmont 7131 Rutherford Road Baltimore, Maryland 21207	Boulevard and Woodlawn Drive; thence running with and binding on the Northern right-of-way line of Security Boulevard South 82 ⁰ 19'46" West 150.00 feet: thence leaving said right-of-way line North 04001'13"
ation appearing on the	DATE & TIME: Monday, August 27, 1984 at 10:30 A.M. PUBLIC HEARING: Room 106, County Office Building, 111 W. Chesapeake Avenue, Towson, Maryland Published in THE JEFFERSONIAN, a weekly newspaper printed	Re: Petition for Special Exception NW/cor. Security Blvd. & Woodlawn Dr.	on the West side of Woodlawn Drive; thence running with and binding on the Western right-of-way line of Woodlawn Drive by a curve to the
the secend publication appearing on the	The Zoning Commissioner of Baltimore County, by authority of the Zoning Act and Regu- lations of Baltimore County. and published in Towson, Baltimore County, Md., appearing on lations of Baltimore County.	Equitable Life Assurance Soc. of the U.S., Petitioner Case No. 85-56-X	right having a radius of 1,060.00 feet, an arc length of 120.00 feet, said curve being subtended by a chord bearing South 04 ⁰ 01'08" East 119.93 feet to a point of compound curvature: thence by a fillet
oay of19	Petition for Special Exception for the use of a food store with less tunn 5,000 ag.	Dear Sir:	curve to the right having a radius of 92.00 feet, an arc length of 95.04 feet, said curve being subtended by a chord bearing South 28° 49'04" West 90.87 feet to the place of beginning.
the third publication appearing on theday of	ft. in combination with an existing service station under Section 405.4 (D.8) Being the property of Equi-	This is to advise you that \$47.00 is due for advertising and posting of the above property.	Containing in all 30,892.92 square feet or 0.709 acres of land, more or less.
THE NORTHWEST STAR	table Life Assurance Soc. of the U.S., as shown on plat plan filed with the Zoning Department. In the event that this Petition is granted, a building	This fee must be paid and our zoning sign and post returned on the day of the hearing before an Order is issued. Do <u>not</u> remove sign until day of hearing.	
Phyllic Hotelland	permit may be issued within the thirty (30) day appeal period. The Zoning Commissioner will, however, entertain any	Please make the check payable to Baltimore County, Maryland, and remit to Mrs. Arlene January, Zoning Office, Room 113, County Office Building,	Mark A. Riddle Md. Reg. P.L.S. No. 244 G. 26. 84 Date
Hanager //	request for a stay of the issu- ance of said permit during this period for good cause shown. Such request must be received in writing by the date of the	Towson, Maryland 21204, before the hearing.	THE OF MARINE
Cost of Advertisement \$20.00	hearing set above or made at the hearing. By Order Of ARNOLD JABLON Zoning Commissioner of Baktimore County	Sincerely,	* THE SECOND SEC
	of Bakimore County Aug. 9. Cost of Advertising 2200	BALTIMORE COUNTY, MARYLAND No. 133269 DID JABLON DEFIC OF FINANCE - REVENUE DIVISION DID JABLON	
		MISCLILANEOUS CASH RECEIPT 1g Commissioner 8.29-84 ACCOUNT 01-615-100	LINE SURVEYORD
		AMOUNT 47.00	Parel 11 _ +356
		RECEIVED Lyon acounter	Hom + 356
		FROM: Parting Talu- 85-56-X	1/25/01
		6 644**********************************	
		VALIDATION OR SIGNATURE OF CASHIER	STV ENGINEERS, Engineers, Architects, Planners, Construction Managers, Professional Number Firms STV/Baltimore Transportation Associates; STV/Lyon Associates, STV/Management Consultants Group; STV/

PETITION FOR SPECIAL EXCEPTION not being adversely affected, the special exception should be granted. IN RE: PETITION SPECIAL EXCEPTION It is class that the zoning regulations permit the use requested by the BEFORE THE 2nd Election District Therefore, IT IS ORDERED by the Zoning Commissioner of Baltimore County, NW/corner Security Boulevard and Woodlawn Drive - 1st Petitioner in a B.M.-C.C.C. Zone by special exception. It is equally clear ZONING: Petition for Special Exception ZCNING COMMISSIONER this 30th day of August, 1984, that the Petition for Special Exception for a Election District that the proposed use would not be detrimental to the primary uses in the LOCATION: Northwest corner Security Boulevard and Woodlawn OF BALTIMORE COUNTY Equitable Life Assurance Soc. food store with less than 500 square feet of retail sales in combination with of the U.S., vicinity of the proposed use. Therefore, it must first be determined whether Case No. 85-56-X an existing service station be and is hereby GRANTED, from and after the date DATE & TIME: Monday, August 27, 1984 at 10:30 A.M. Petitioner the conditions as delineated by Section 502.1 are satisfied by the Petitioner. of this Order, subject, however, to the following restrictions: PUBLIC HEARING: Room 106, County Office Building, 111 W. Chesapeake After reviewing all of the testimony and evidence presented, it appears Avenue, Towson, Maryland 1. The Petitioner may apply for its building permit and be The Zoning Commissioner of Baltimore County, by authority of the Zoning FINDINGS OF FACT AND CUNCLUSIONS OF LAW granted same upon receipt of this Order; however, Petithat the special exception as applied for should be granted, with certain Act and Regulations of Baltimore County, will hold a public hearing: tioner is hereby made aware that proceeding at this time it at its own risk until such time as the applicable restrictions as more fully described below. The Petitioner herein requests a special exception for a food store with appellate process from this Order has expired. If, for Petition for Special Exception for the use of a food store with less than 5,000 sq. ft. in combination with an existing whatever reason, this Order is reversed, the Petitioner The Petitioner had the burden of adducing testimony and evidence which less than 500 square feet of retail sales in combination with an existing service would be required to return, and be responsible for service station under Section 405.4 (D.8) returning, said property to its original condition. would show that the proposed use met the prescribed standards and requirements Being the property of Equitable Life Assurance Soc. of the U.S., as station, as more fully described on Petitioner's Exhibit 1. shown on plat plan filed with the Zoning Department. A detailed landscaping plan must be submitted to the set forth in Section 502.1. In fact, the Petitioner has shown that the proposed Shell Oil Company, the lessee, by Michael Kovin, a designer for Lyon Office of Current Planning pursuant to the Baltimore In the event that this Petition is granted, a building permit may be use would be conducted without real detriment to the neighborhood and would not County Landscaping Manual. issued within the thirty (30) day appeal period. The Zoning Commissioner Associates, appeared on behalf of the Petitioner. There were no Protestants. will, however, entertain any request for a stay of the issuance of said A copy of the overall shopping center plan, of which actually adversely affect the public interest. The facts and circumstances of permit during this period for good cause shown. Such request must be Testimony indicated that the property is zoned B.M.-C.C.C. The site this site is a part, must be submitted to the Office received in writing by the date of the hearing set above or made at the use proposed by the Petitioner do not show that the proposed use at the of Current Planning. presently has an existing service station, and the lessee wishes to renovate the hearing. particular location described by Petitioner's Exhibit 1 would have any adverse the station by relocating the gas islands and constructing a 20' X 40' mini-BY ORDER OF ARNOLD JABLON impact above and beyond those inherently associated with such a special exception market. The three existing islands, one with a 6' X 12' kiosk, would be replaced ZONING COMMISSIONER use irrespective of its location within the zone. Schultz v. Pritts, 432 A.2d OF BALTIMORE COUNTY by two 5' X 28' pump islands, with two dispensers. Baltimore County 1319 (1981). The area where the site is located is extensively commercial. The proposed use will not be detrimental to the health, safety, or general The building is comparatively small and would only minimally serve those cc: Equitable Life Assurance Soc. of the U.S. We fare of the locality, nor tend to create congestion in roads, streets, or Jutilizing the gas station. Mr. Kovin testified that there will be no expected People's Counsel alleys therein, nor be inconsistent with the purposes of the property's zoning ase in traffic generated by the proposed addition of the market. Indeed, Shell Oil Company Eclassification, nor in any other way inconsistent with the spirit and intent of market could not exist without the gas sales. There will be no changes to Mr. Steve McCalmont, c/o Lyon Associates the existing entrances, nor any impact on stacking, which is accommodated easily Pursuant to the advertisement, posting of property, and public hearing You this large site. , and it appearing that by reason of the requirements of Section 502.1 The Petitioner seeks relief from Section 405.4.D.8, pursuant to Section having been met and the health, safety, and general welfare of the community , Baltimore County Zoning Regulations (BCZR). BALTIMORE COUNTY, MARYLAND PEOPLE'S COUNSEL 11/16/84 - Following were notified of hearing set for Thurs. Jan. 31, '85, at 10 a.m.: OLD COURT HOUSE TOWSON, MARYLAND 21204 H. Johnston 494-2188 CERTIFICATE OF POSTING R. Tambascio PHYLLIS COLE FRIEDMAN PETER MAX ZIMMERMAN ZONING DEPARTMENT OF BALTIMORE COUNTY 85-56-X S. McCalmont September 27. 1984 PEOPLE'S COUNSEL Walter J. Caton, Sr. DEFUTY PEOPLE'S COUNSEL P. Friedman N. Gerber and J. Hoswell September 26, 1984 A. Jablon, J. Jung, J. Dyer The Honorable Arnold Jablon r. Blitram Harrington Zoning Commissioner Phyllis Cole Friedman, Esquire County Office Building People's Counsel for Baltimore County Towson, Maryland 21204 Old Court House Towson, Maryland 21204 RE: Equitable Life Assurance Soc. of the U.S., Zoning Case No. 85-56-X RE: Case No. 85-56-X Equitable Life Assurance Dear Arnold: Soc. of the U.S.. Petitioner A Mr. Walter Caton, Sr., who is a representative of the W. Bell Merchants Assn. located in the shopping center where the above-referenced Dear Mrs. Friedman: property is situated has contacted me and stated that no sign was posted for the petition for special exception prior to the hearing on Monday, Thank you for your letter dated September 26, 1984 as to the above-August 27, 1984. He states that the first he knew of this matter was on referenced matter. September 16, 1984 when a sign appeared. Notwithstanding the potential impropriety alleged by Mr. Caton, I believe Although Mr. Caton has noted an appeal from your decision, in view his appeal, in effect, will cure all errors that may have occurred before me of the procedural defect, I wondered whether you might prefer to take upon the County Board of Appeals' hearing of the case. See Boehm v. Anne Arunthe case back for rehearing on the theory that there has been fraud, del County, 459 A.2d 590, 599 (1983). If no appeal had been entered or if the appeal now filed should be dismissed before the de novo hearing is held, I would mistake, or irregularity. Mr. Caton has stated that he would be willing to file an affidavit and that there are others who can corroborate the agree to reopen the case in order to insure that there had been compliance with absence of the sign. the procedural requirements of notice. Very truly yours, At this point, the de novo hearing before the Board will provide Mr. Caton every opportunity to vent his opposition to the special exception requested by · 表示是 化基化油酸 (1) 人名英格兰人姓氏克里特的变体 医水体 (1) 电影 the Petitioner. Parenthetically, our records show that the sign was posted on Mindle Drive August 10, 1984. Phyllis Cole Friedman NW/cor, Security Blvd. and Woodlawn Drive People's Counsel for Baltimore County PCF:sh cc: Mr. Walter Caton, Sr. ARNOLD JABLON 6630 Security Blvd. Zoning Commissioner Baltimore, MD 21207

County Board of Appeals of Baltimore County Mr. Steve McCalmont, Lyon Associates, 7131 Rutherford Road, Balti-Room 200 Court Mouse IN RE: PETITION SPECIAL EXCEPTION IN THE MATTER
OF THE APPLICATION OF more, Maryland 21207, Phyllis C. Friedman, Esquire, People's Coun-NW/corner Security Boulevard Towson, Maryland 21204 BOARD OF APPEALS and Woodlawn Drive **EQUITABLE LIFE ASSURANCE** (301) 494-3180 sel of Baltimore County, Room 223, Courthouse, Towson, Maryland 1st Election District SOCIETY OF THE U.S. * OF BALTIMORE COUNTY FOR SPECIAL EXCEPTION Equitable Life Assurance Soc. 21204, Malcolm F. Spicer, Jr., Esquire, County Attorney, Office of February 14, 1985 FOR THE USE OF A FOOD of the U.S., Case No. 85-56-X Law, Courthouse, Towson, Maryland 21204 Petitioner SERVICE STATION Walter J. Caton, Sr., Vice President W. Bell Merchants Association NW corner SECURITY BLVD. and WOODLAWN DRIVE 6642 Security Boulevard Baltimore, MD 21207 ENTRY OF APPEARANCE Please enter my appearance on behalf of Shell Oil Company Re: Case No. 85-56-X in the above captioned matter. Equitable Life Assurance Society of the U. S. This case comes before the Board on appeal from the decision of the Dear Mr. Caton: Zoning Commissioner, dated August 30, 1984, granting the petition for a special Enclosed herewith is a copy of the Opinion and Order passed today by the County Board of Appeals in the above entitled case. exception for a food store with less than 5,000 square feet of retail sales in combination with an existing service station. Seiland and Jednorski Petitioners presented two witnesses; one, Robert King, 4705 Bellwood 25 West Chesapeake Avenue Very truly yours, Towson, Maryland 21204 Green, Columbia, Maryland, an engineer, testified that the requested special exception 321-8200 would comply with all requirements of \$502 of the Baltimore County Zoning Regulations CERTIFICATE OF SERVICE (BCZR) and would not adversely impact the health, safety, and general welfare of the I HEREBY CERTIFY, That on this 24th day of January, 1985, a copy of the aforegoing Entry of Appearance was mailed, postage Enclosure Robert Tambascio testified on behalf of Shell Oil Company that the paid, to Arnold Jablon, Zoning Commissioner of Baltimore County, cc: H. L. Johnston purpose of the store was for the convenience of gasoline customers and would pro-R. M. Tambascio Room 109, 111 West Chesapeake Avenue, Towson, Maryland 21204; Mr. Steve McCalmont John O. Seiland, Esquire vide ancillary income for the lessee. H. L. Johnston, The Equitable Life Assurance Society of the United Phyllis Cole Friedman The Protestant in the case, Walter J. Caton, Sr., testified on behalf of Norman E. Gerber States, 1875 I . reet, N. W., Suite 1140, Washington, D. C. 20006, James G. Hoswell himself and W. Bell Merchants Association. He stated that his primary objection was Jean M. H. Jung James E. Dyer SEILAND & JENOR a failure to observe a posting of the subject property and failure to demonstrate a SUITE 204 BUITE 204 need for the proposed convenience store. 28 W. CHESAPEAKE AVE 28 W. CHESAPEAKE AVE TOWSON, MD 21204 (301) 321-8200 (301) 321-8200 The element of posting becomes moot inasmuch as this hearing is de novo, and need is not an item to be considered by this Board. The Protestant EQUITABLE LIFE ASSURANCE - #85-56-X

failed to demonstrate that the proposed special exception would adversely impact

the health, safety, and general welfare of the community, and since this proposed

use is permitted in the existing zone, the Board has no alternative but to affirm

For the reasons set forth in the aforegoing Opinion, it is this 14th

Any appeal from this decison must be in accordance with Rules B-1

COUNTY BOARD OF APPEALS OF BALTIMORE COUNTY

Apuun

day of February, 1985, by the County Board of Appeals, ORDERED that the Order of

the Zoning Commissioner, dated August 30, 1984, be affirmed and that the special

exception petitioned for, be and the same is hereby GRANTED, including the

ORDER

the decision of the Zoning Commissioner of Baltimore County.

restrictions imposed by the Zoning Commissioner.


through B-13 of the Maryland Rules of Procedure.

BEFORE

COUNTY BOARD OF APPEALS

BALTIMORE COUNTY

NO. 85-56-X

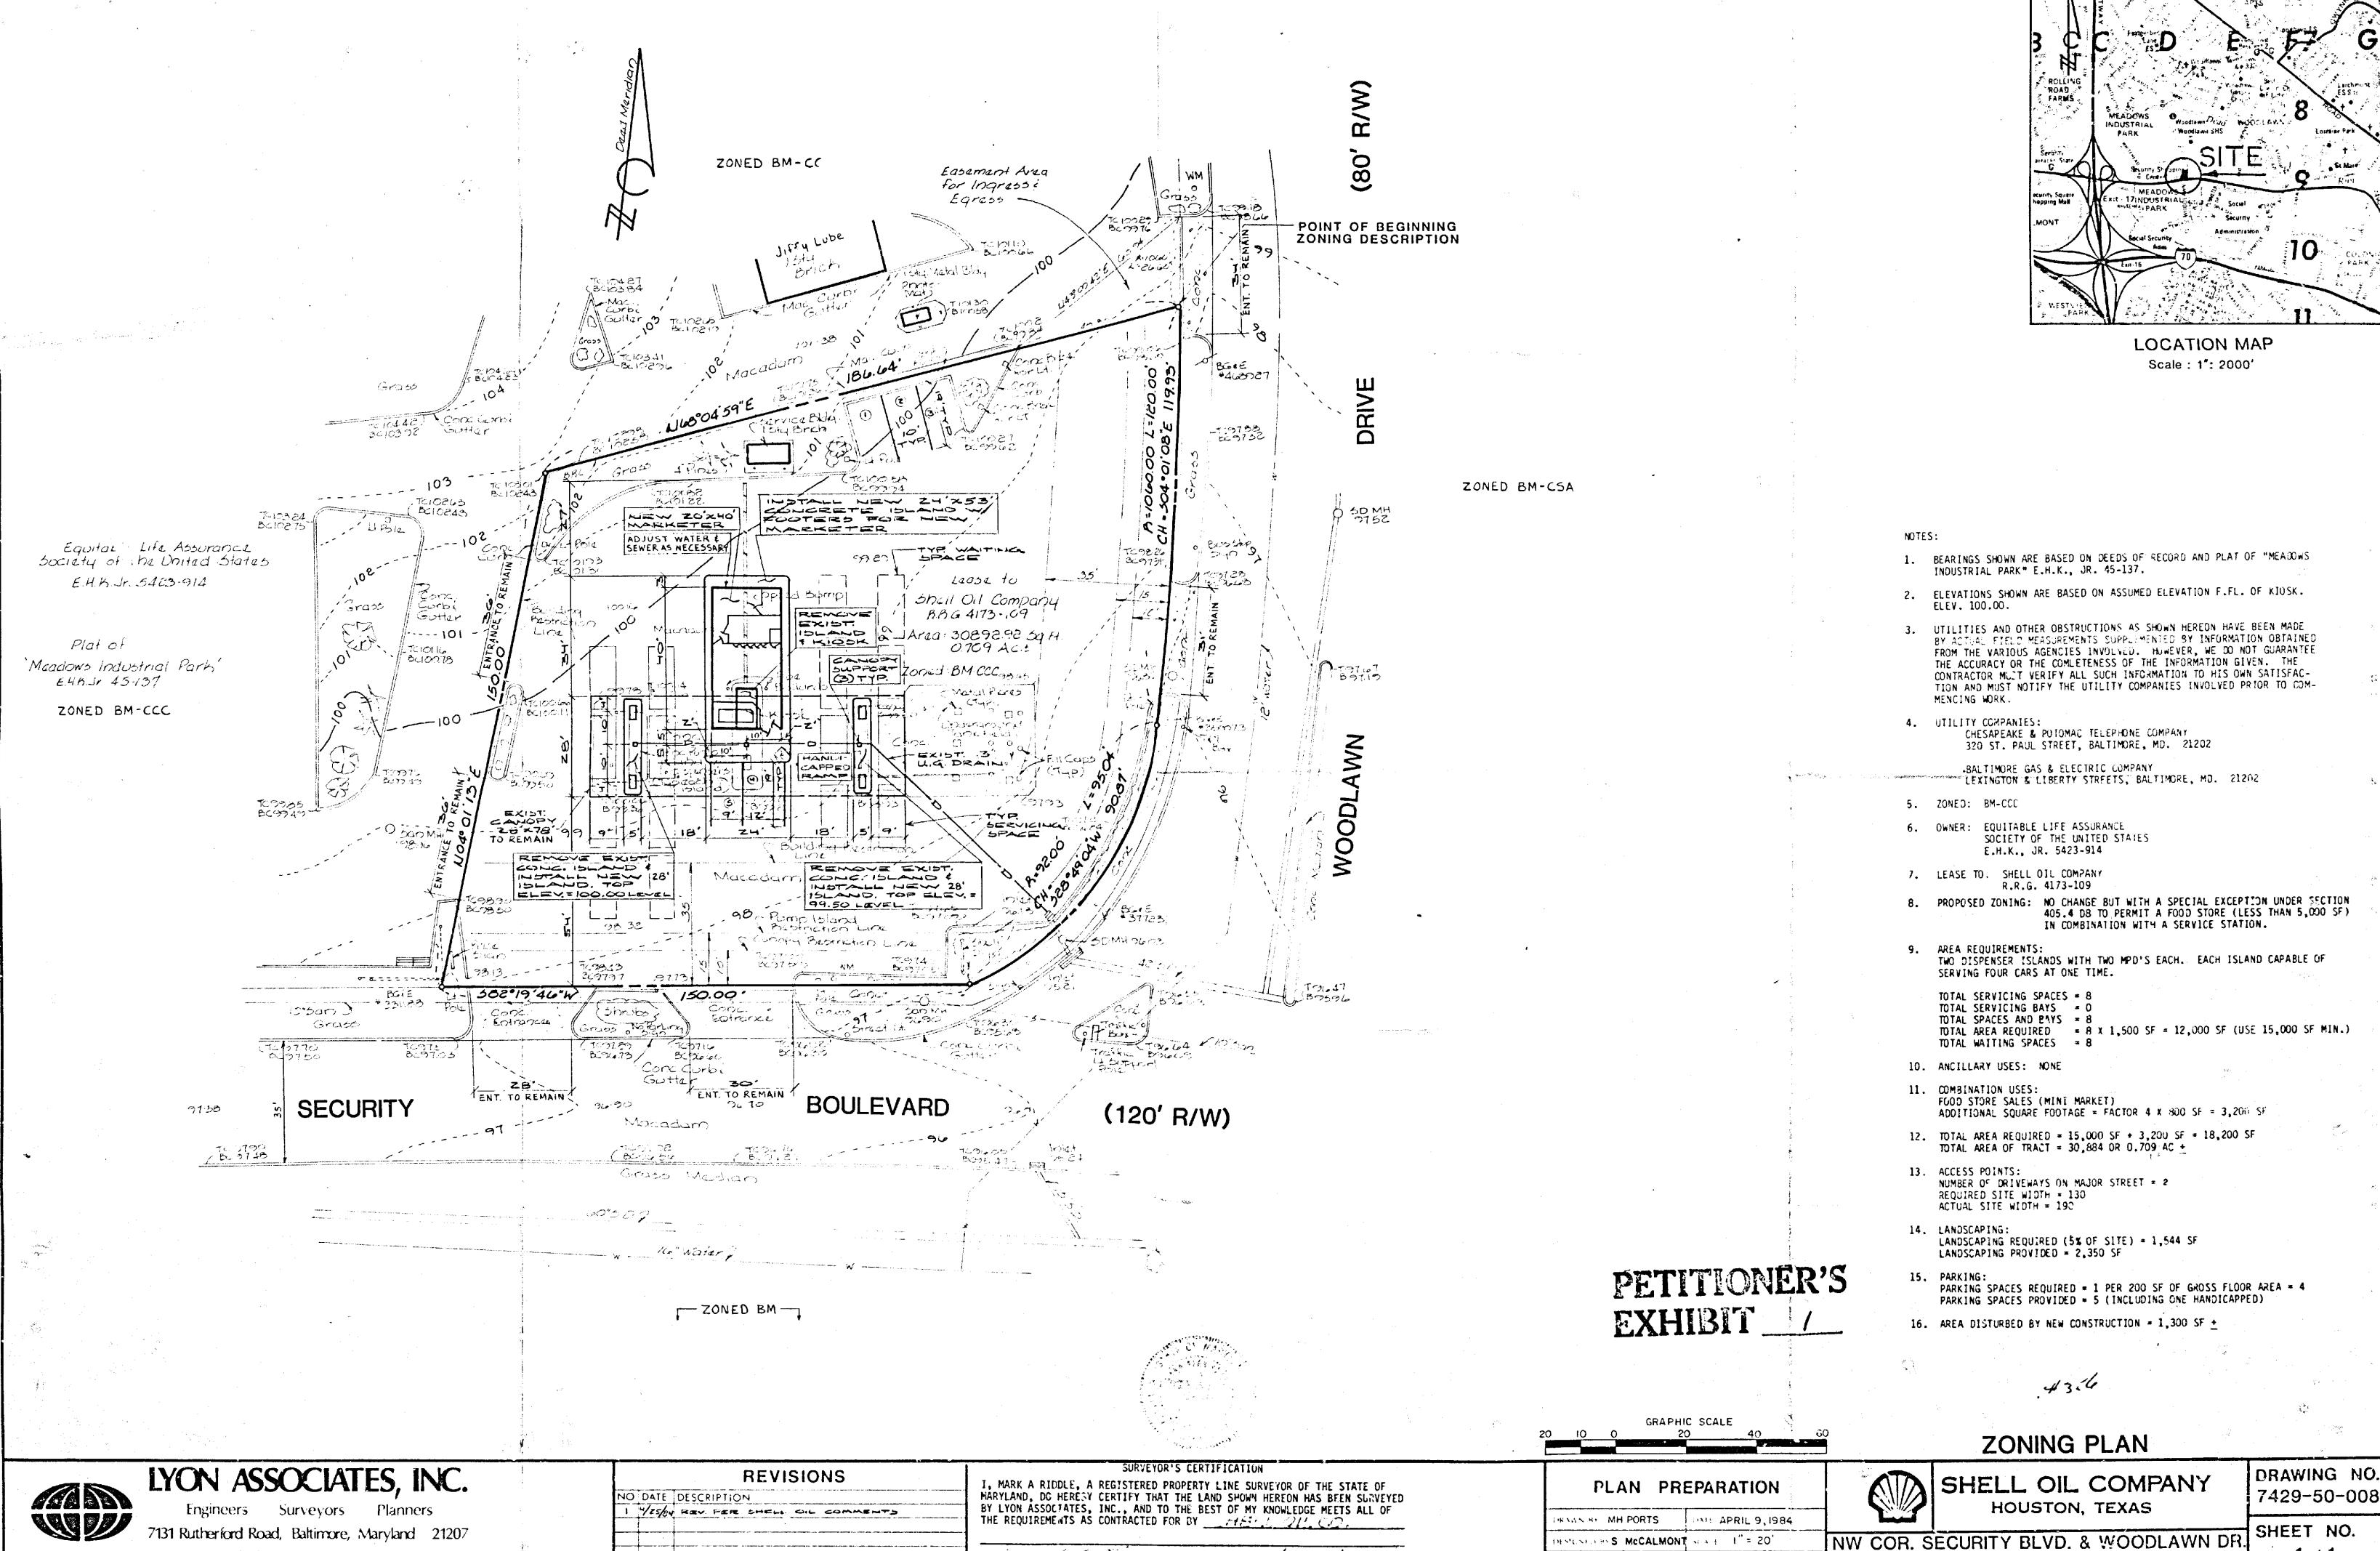


MARK A. FILDLE. L.S NO. 244


4. 1. 1.1

Telephone: 301-944-9112

1 of 1

ELECT. DIST. 1 BALTO. CO., MD

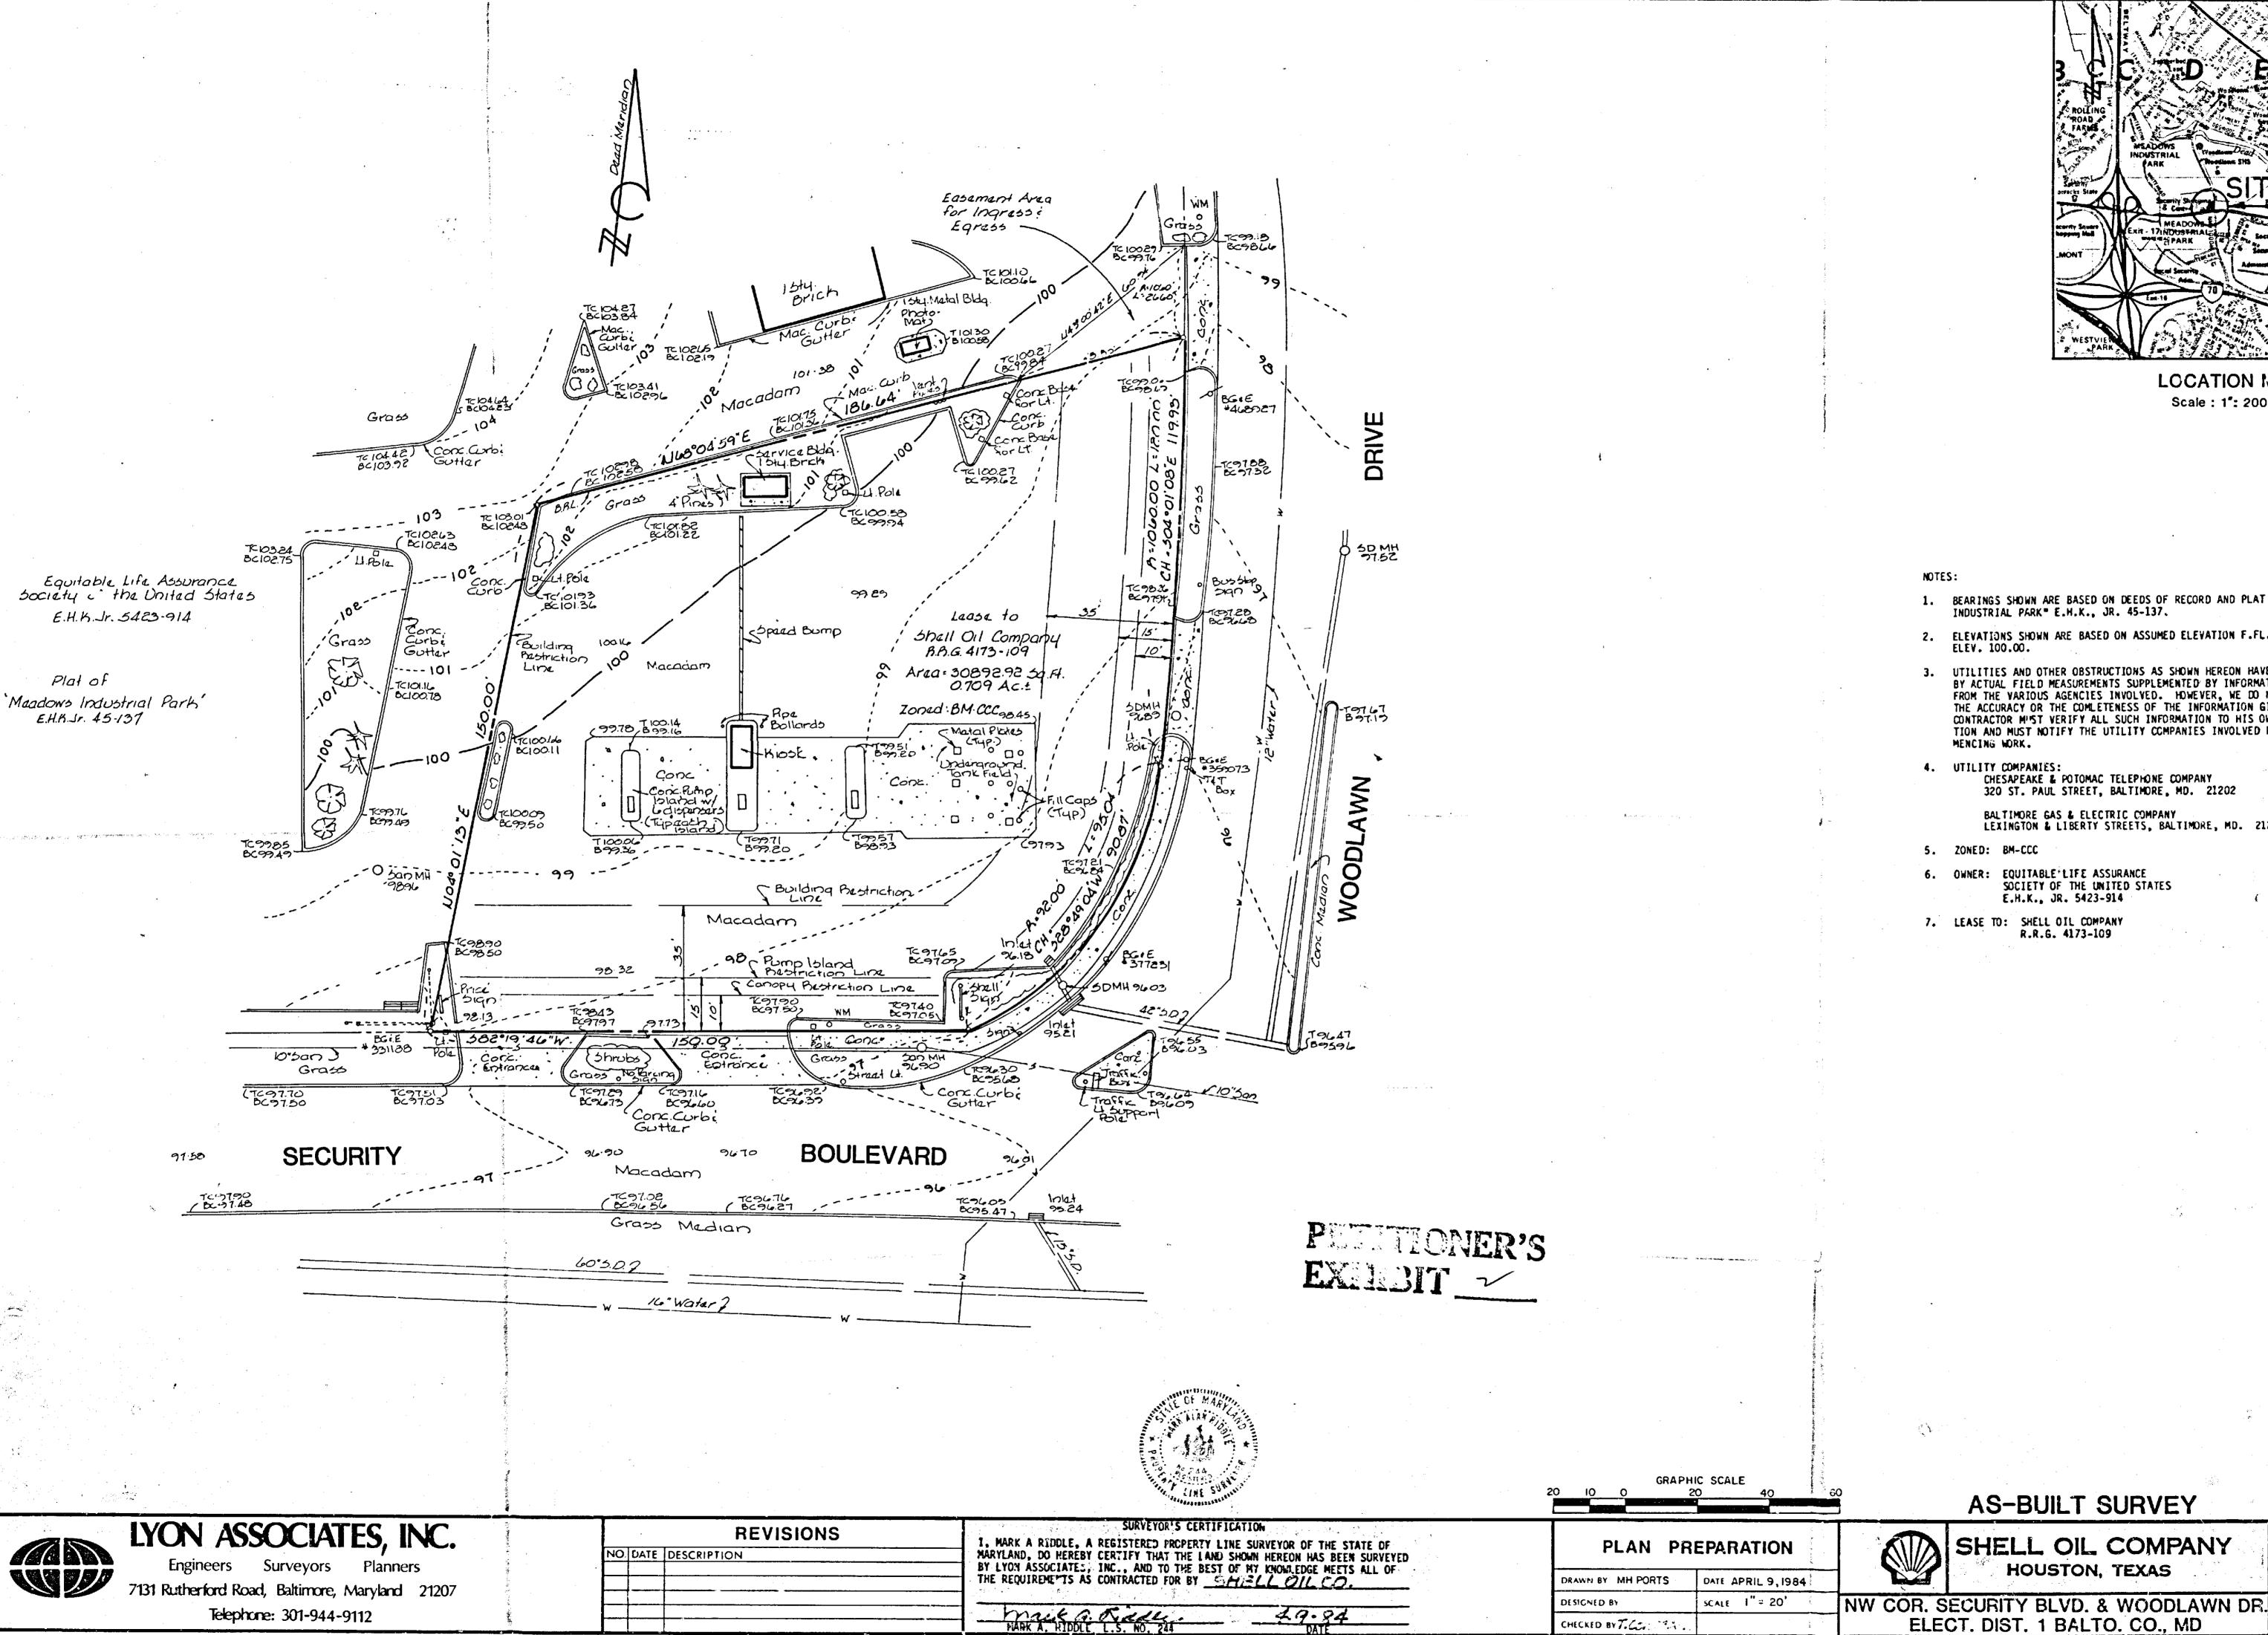

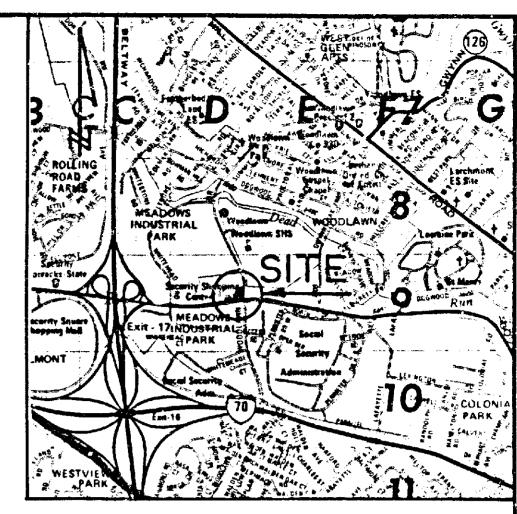

LOCATION MAP

Scale: 1": 2000"

- 1. BEARINGS SHOWN ARE BASED ON DEEDS OF RECORD AND PLAT OF "MEADOWS INDUSTRIAL PARK" E.H.K., JR. 45-137.
- 2. ELEVATIONS SHOWN ARE BASED ON ASSUMED ELEVATION F.FL. OF KIOSK. ELEV. 100.00.
- 3. UTILITIES AND OTHER OBSTRUCTIONS AS SHOWN HEREON HAVE BEEN MADE BY ACTUAL FIELD MEASUREMENTS SUPPLEMENTED BY INFORMATION OBTAINED FROM THE VARIOUS AGENCIES INVOLVED. HOWEVER, WE DO NOT GUARANTEE THE ACCURACY OR THE COMLETENESS OF THE INFORMATION GIVEN. THE CONTRACTOR MIST VERIFY ALL SUCH INFORMATION TO HIS OWN SATISFAC-TION AND MUST NOTIFY THE UTILITY COMPANIES INVOLVED PRIOR TO COM-MENCING WORK.
- 4. UTILITY COMPANIES: CHESAPEAKE & POTOMAC TELEPHONE COMPANY 320 ST. PAUL STREET, BALTIMORE, MD. 21202

BALTIMORE GAS & ELECTRIC COMPANY LEXINGTON & LIBERTY STREETS, BALTIMORE, MD. 21202

- 6. OWNER: EQUITABLE LIFE ASSURANCE SOCIETY OF THE UNITED STATES E.H.K., JR. 5423-914
- 7. LEASE TO: SHELL OIL COMPANY R.R.G. 4173-109

AS-BUILT SURVEY

SHELL OIL COMPANY HOUSTON, TEXAS

DRAWING NO. 7429-50-008

SHEET NO. 1 of 1